




NOT TO SCALE

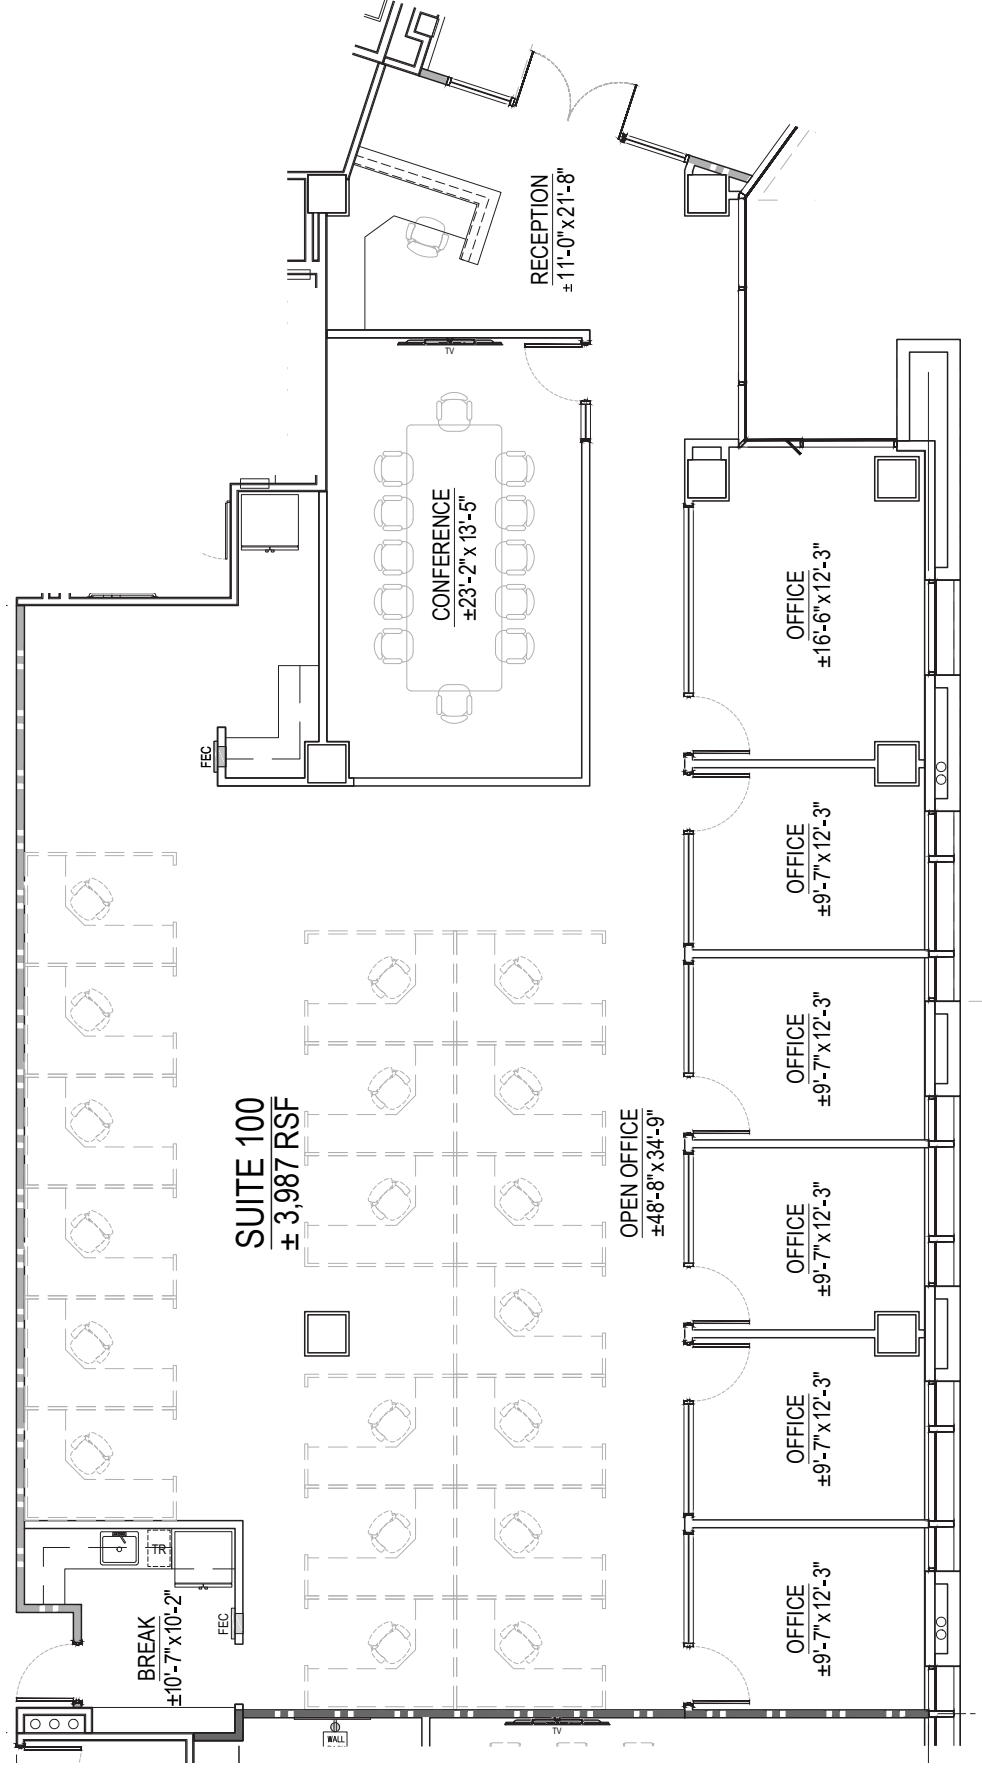

SHELL
Commercial Investment Real Estate
480-443-3992

602-859-0506
JOHN QUATRINI
ASSOCIATE BROKER
john@shellcommercial.com

602-471-2981
SUZANNE ENRIGHT
SENIOR ASSOCIATE
suzanne@shellcommercial.com

PROPERTY OWNED
& MANAGED BY

